

1706-79

ISLAND COUNTY HEALTH DEPARTMENT
P. O. BOX 700
COUPEVILLE, WASHINGTON 98239

APPLICATION TO CONSTRUCT, ALTER, OR REPAIR A SEWAGE DISPOSAL SYSTEM

as Built

OWNER'S NAME Bob Bodin Const PHONE: 675-1864
ADDRESS 1075 W Crosby Rd. Oak Harbor Wn. 98277
NAME OF WATER SYSTEM SHIRONA WATER SYSTEM

LEGAL DESCRIPTION

SR#81-1452

PARCEL NUMBER _____
NAME OF PLAT: SHIRONA DIVISION: 1 BLOCK: _____ LOT: 22
OR Short Plat No: _____ Parcel: _____
OR Tax Lot: _____ Section: _____ Township: _____ Range: _____
C Meets and Bounds _____

Location of Construction Site: DARKIE P. in SHIRONA PLAT OFF HESTIE LAKE ROAD

SITE INFORMATION

Lot Width: 99 ft. Lot Depth: 140 ft. Area: 13860 (sq. ft.)
Type of use: Residence No. of Bedrooms 3
Fill Information: Depth: _____ Width: _____ Length: _____ Date: _____

SOIL TYPES	DEPTH	AVERAGE PERC RATE:
<u>Gravel</u>	<u>0-15</u>	<u>2</u>
<u>Loam sand + gravel</u>	<u>15-78</u>	<u>11-21-79</u>
		DATE OF SOIL LOGS
		DEPTH OF GROUNDWATER
		DEPTH OF IMPERVIOUS SOIL

CERTIFICATION

We certify that this permit was issued for the sewage disposal system diagramed on the reverse side. We also certify that to deviate from original plan, such as (a) location of home or lot; (b) size of home; (c) placement of septic tank inlet without first obtaining written approval of the Island County Health Department and the Installer, automatically VOIDS this permit.

OWNER'S SIGNATURE: _____ Date: _____
INSTALLER'S SIGNATURE: W. J. Smith Date: 11-21-79
BUILDER'S SIGNATURE: _____ Date: _____

FOR HEALTH DEPARTMENT USE ONLY

Plan approved JGT Permit No.: 1706-79 Receipt No: 1706 Date: 11/27/79
Plan Disapproved _____
Final Inspection: Approved: S. Hobbs Rejected: Done by Installer By: _____ Date: 3/31/80

PER SANITARY CODE OF ISLAND COUNTY EACH INDIVIDUAL SEWAGE DISPOSAL SYSTEM MUST BE AVAILABLE FOR HEALTH DEPARTMENT INSPECTION (24 HOURS NOTICE IS REQUIRED)

PERMIT EXPIRES ONE YEAR FROM DATE ISSUED

TANK CAP. 1000.


DRAIN Fwd 300' — 300' — length 30'

GRAVEL UNDER TILE 108"

ABuent

1706-79

WENT WITH 19.04%
108" UNDER TILE FOUND
COURSE SAND FROM 12" TO
144" AND DUE TO
LANDSCAPING OF LOT

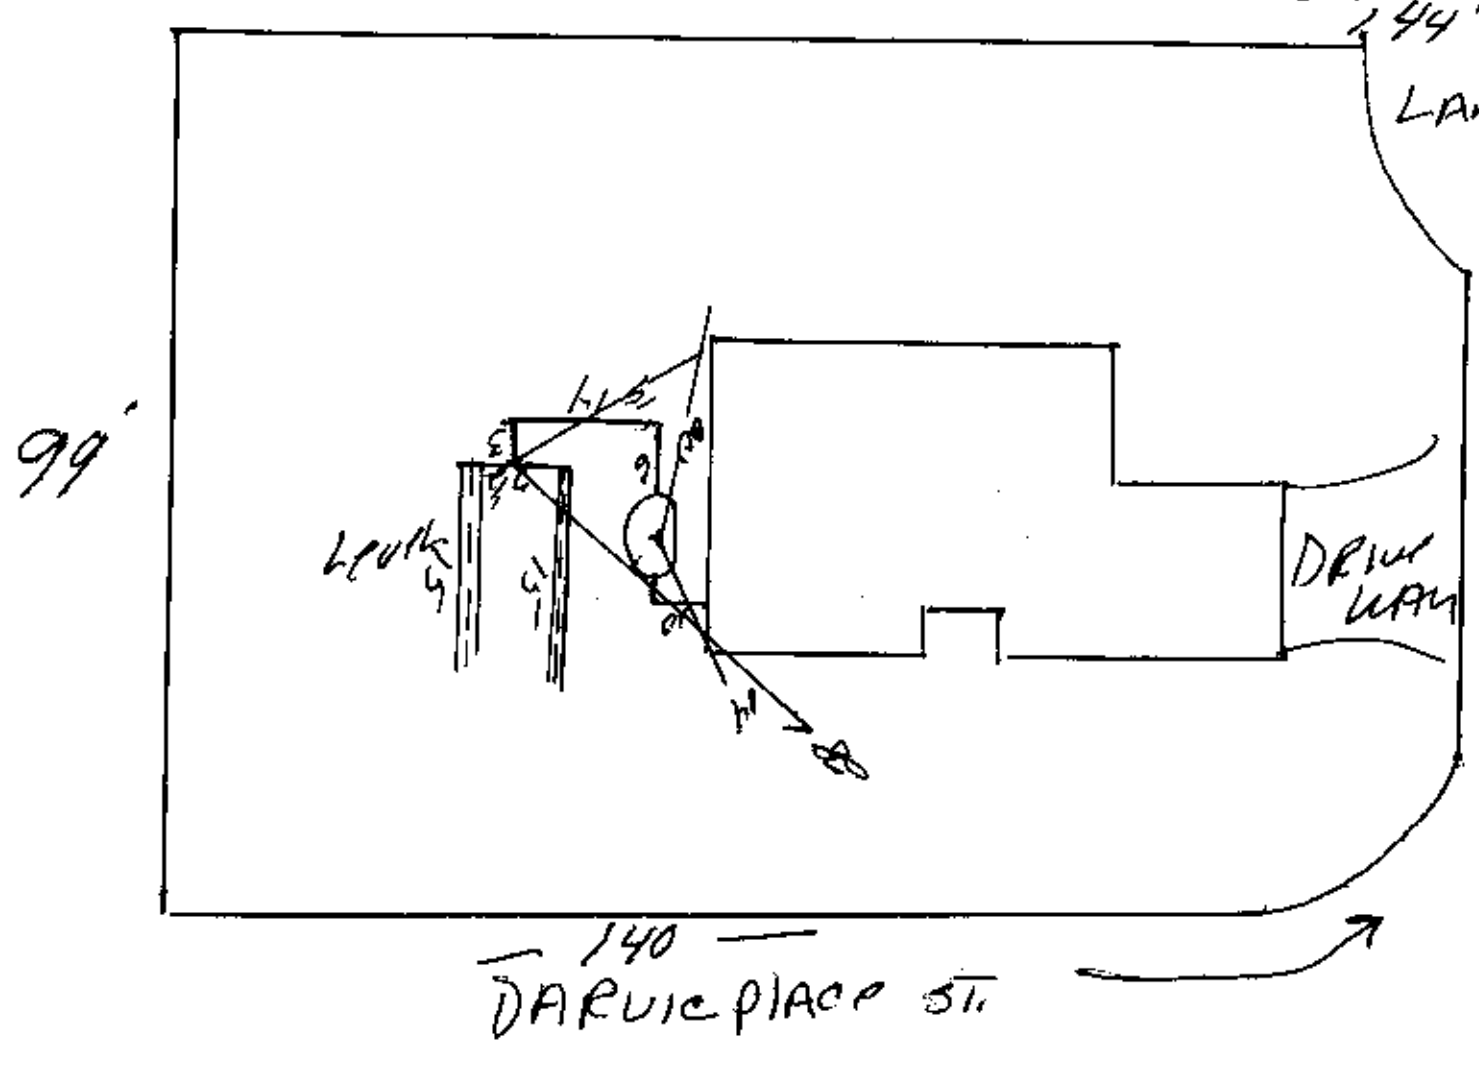

RECEIVED

MAR 27 1980

ISLAND COUNTY
HEALTH DEPARTMENT